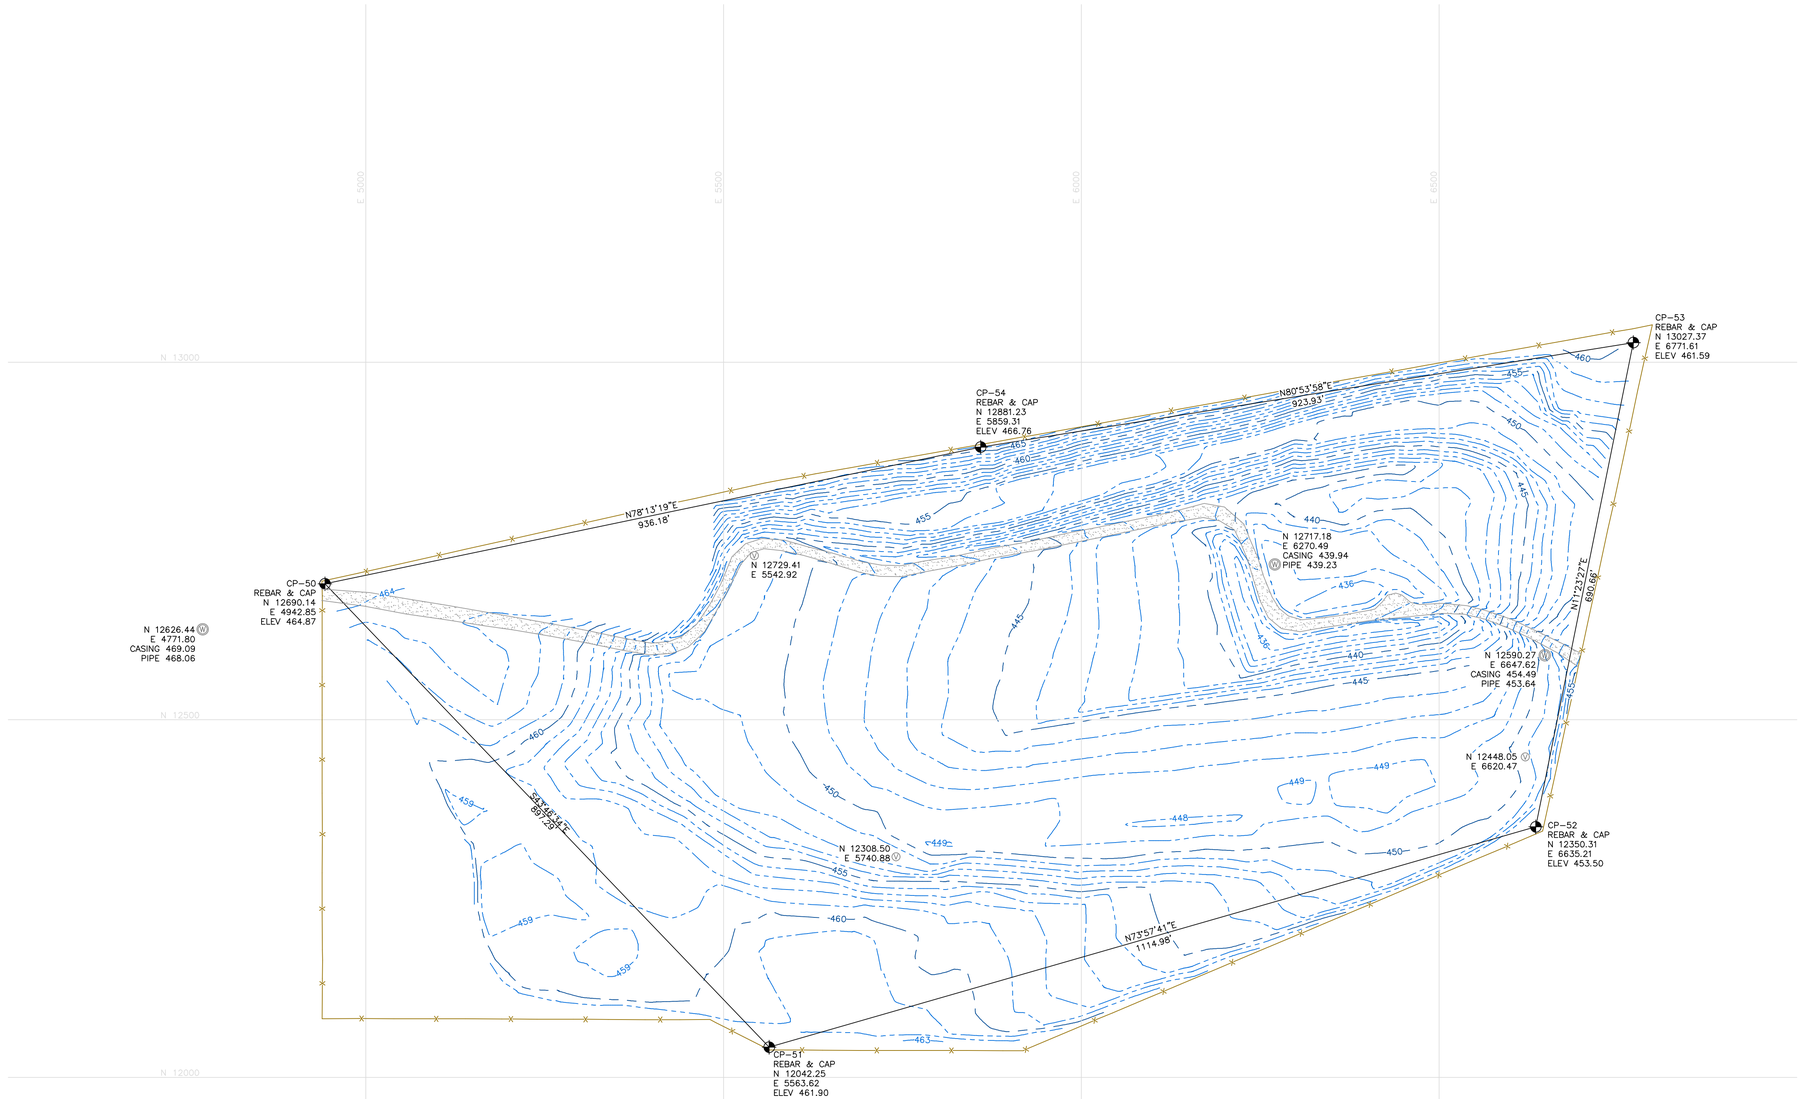

N

SCALE: 1"=100 FEET

100 0 20 50 100

LEGEND

- CONTROL POINT 5/8" REBAR & CAP
- W WELL W/3 BOLLARDS
- V VENT
- X FENCE
- GRAVEL

SURVEYOR'S NOTES

1. DATE OF SURVEY: MAY 22 & JUNE 9, 2025.
2. BASIS OF BEARING: PLANT DATUM.
3. UNITS OF MEASURE: US SURVEY FEET GROUND DISTANCES.
4. VERTICAL DATUM: NGVD29 PLANT DATUM.
5. CONTOUR INTERVAL: 2 FEET.
6. EQUIPMENT/PROCEDURES: TOPOGRAPHY POINTS MEASURED WITH TOPCON HIPER GNSS, RTK METHOD. WELL ELEVATIONS MEASURED WITH SOKKIA B20 AUTO-LEVEL, CONVENTIONAL LEVEL-LOOP PROCEDURES. LINEAR CLOSURES MEET OR EXCEED STANDARDS CONTAINED IN WAC 332-130-090.

SURVEYOR'S CERTIFICATION

I, CHRISTOPHER C. AMMANN, A PROFESSIONAL LAND SURVEYOR REGISTERED IN THE STATE OF WASHINGTON, HEREBY CERTIFY TO THE BEST OF MY KNOWLEDGE, INFORMATION AND BELIEF, THAT THIS MAP IS THE RESULT OF AN ACTUAL FIELD SURVEY CONDUCTED BY ME OR UNDER MY DIRECTION AND THAT ALL INFORMATION SHOWN HEREON IS TRUE AND ACCURATELY SHOWN.

14 JUN 2025

AKS ENGINEERING & FORESTRY, LLC
2475 280TH STREET SUITE 204
RICHLAND, WA 99354
509.905.0219
WWW.AKS-ENG.COM

ENGINEERING · SURVEYING · NATURAL RESOURCES
FORESTRY · PLANNING · LANDSCAPE ARCHITECTURE

ENERGY NORTHWEST
IDC LANDFILL CLOSURE
HANFORD WASHINGTON

AS-BUILT SURVEY

PREPARED FOR
GOODMAN AND MEHLENBACHER ENTERPRISES, INC.

DESIGNED BY:	JTH
DRAWN BY:	JTH
MANAGED BY:	CCA
CHECKED BY:	CCA

DATE: 06/14/2025

CHRISTOPHER CRAIG AMMANN
STATE OF WASHINGTON
25774
REGISTERED PROFESSIONAL LAND SURVEYOR

REVISIONS

JOB NUMBER
12234

SHEET
SV01

AKS DRAWING FILE: 25013 ASBUILT LAYOUT 24X36